



Dundas Street – Old East Village



london.ca

Transportation Advisory Committee – January 28, 2020



Presentation Overview

- Background and Construction Staging
- Typical Cross Sections
- Cycle Track Features
- Proposed Layout
- Discussion

london.ca




Background

Date	Key Milestones
March 2019	East West Bikeway Approved by City Council
March 2019 to December 2019	Detailed Design
June 26, 2019	Public Information Centre #1
October 2019	Third Party Review by Urban Systems Active Transportation Consultants (Vancouver)
December 5, 2019	Public Information Centre #2
January 2020	Tendering
April 2020 to Fall 2020	Phase 1 Construction
April 2021 to Fall 2021	Phase 2 Construction

london.ca




East West Bikeway Evaluation

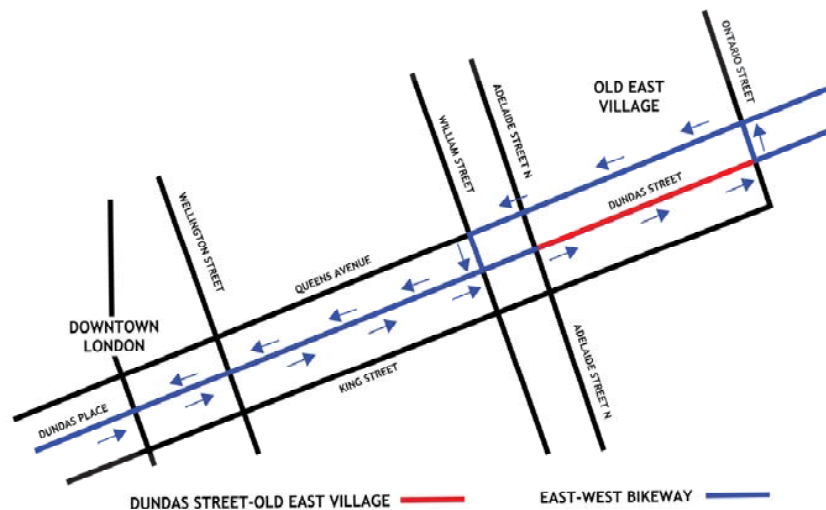

london.ca




Construction Staging

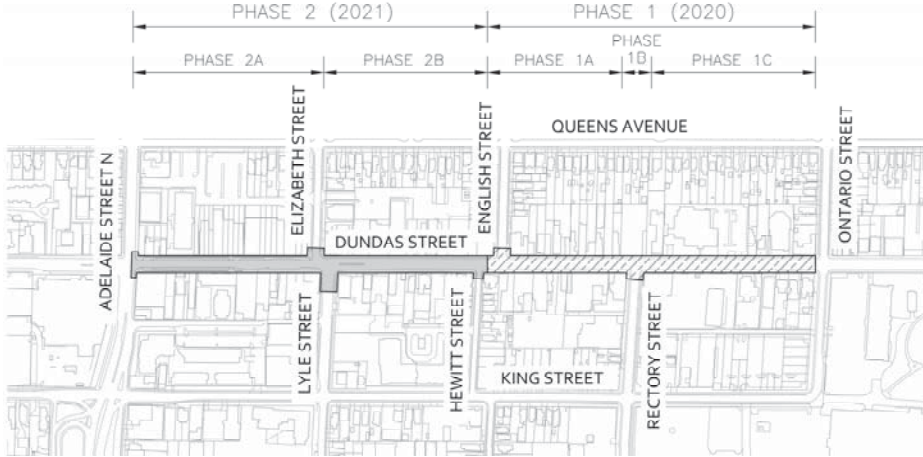

london.ca




Typical Cross Section

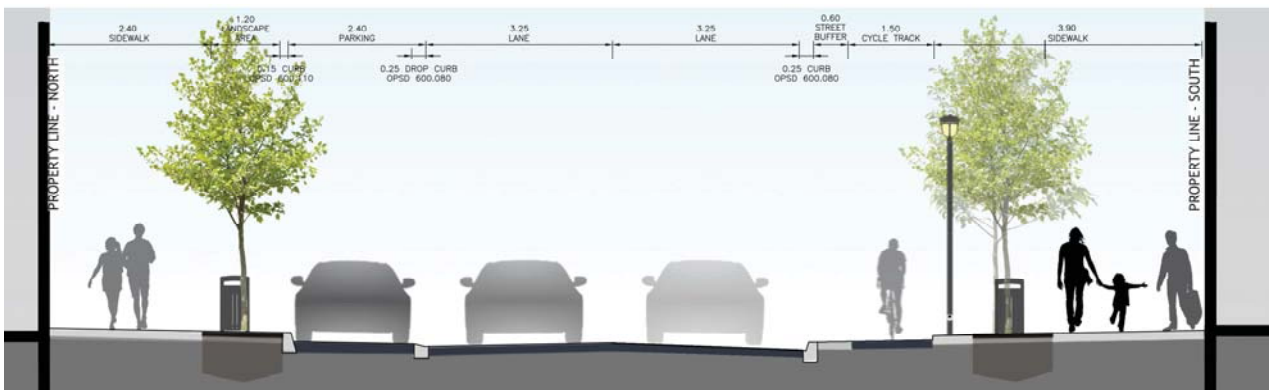

london.ca




Typical Section – Loading Zone

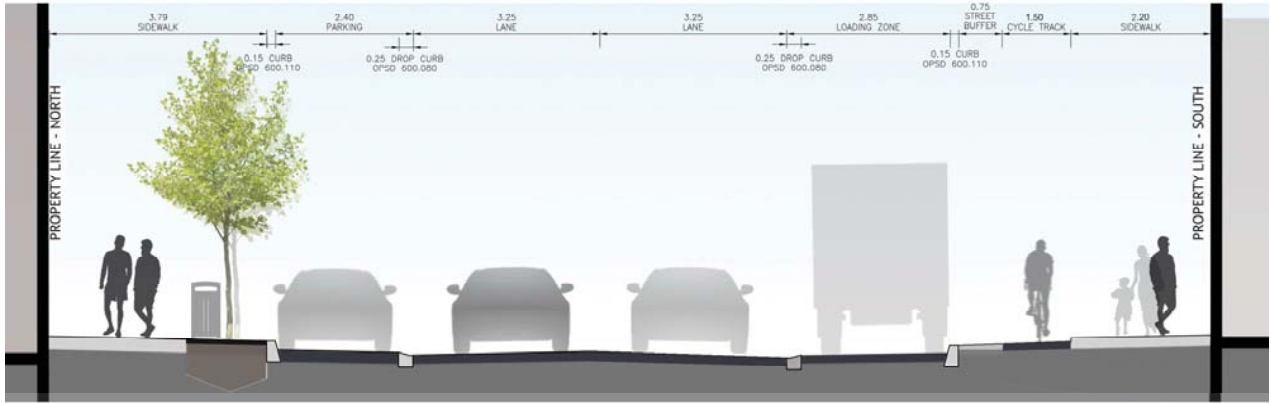

london.ca



Typical Section – Approaching Ontario St.

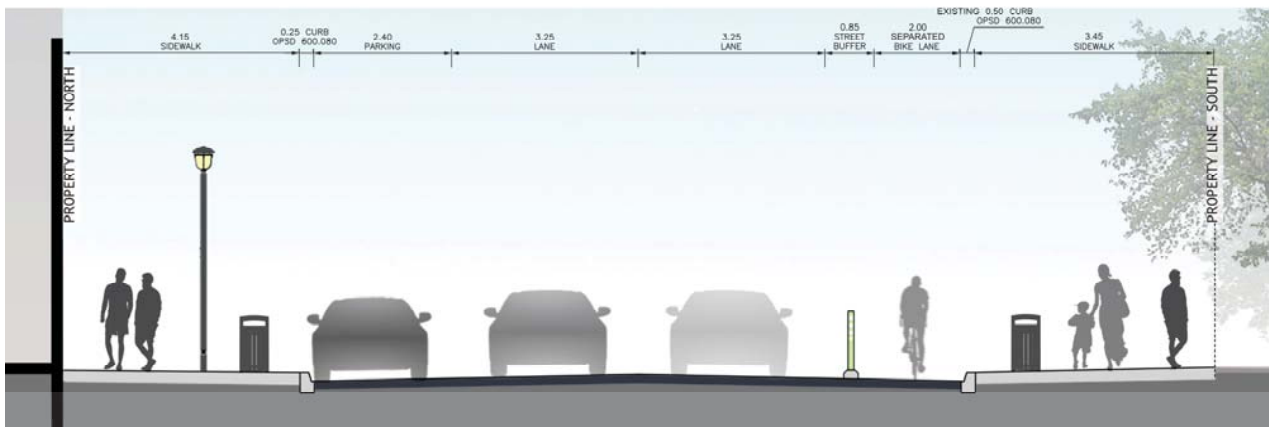

london.ca



Cycle Track – Precedent Images



Typical Layout



Intersection Treatment




Loading Zone Treatment

london.ca




Proposed Layout

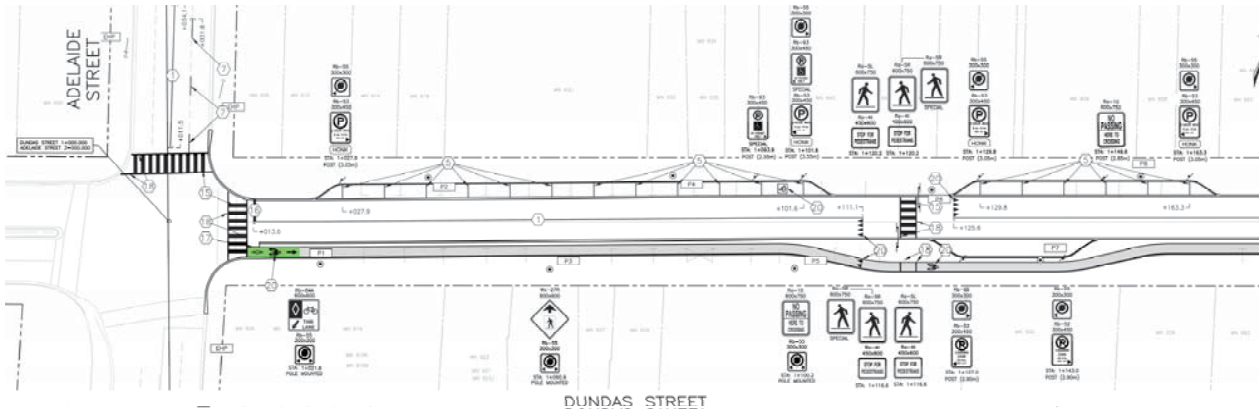

london.ca



Proposed Layout

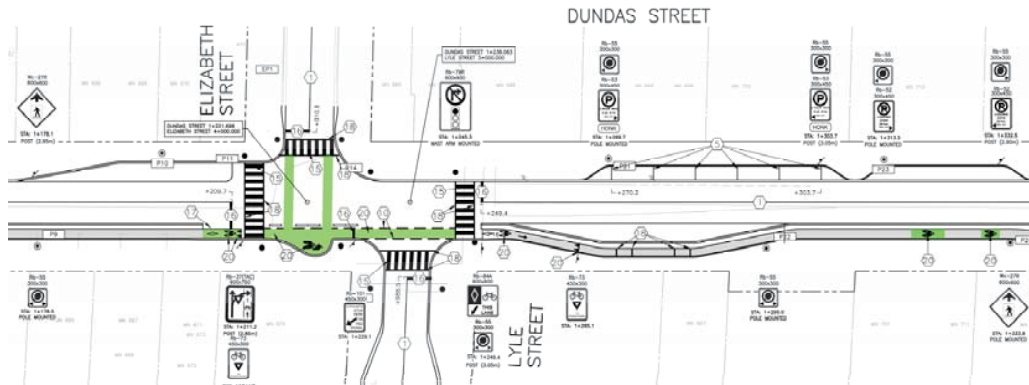


Lyle/Elizabeth Intersection

- Jughandle left turn queue box with push button for a dedicated traffic signal
- Advanced stop bar for cyclists with concrete curb protection
- Bike lanes to Elizabeth Street
- Cycle Track behind pullout bus stop

london.ca



Proposed Layout

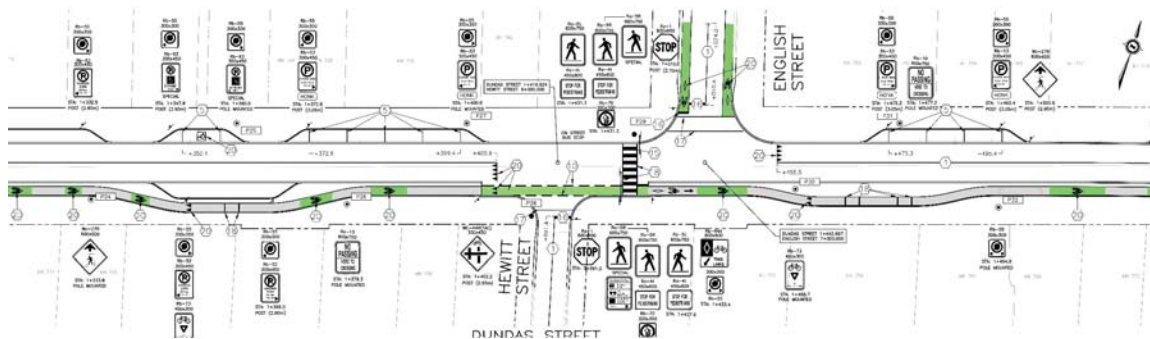


Hewitt/English Intersection

- Converts to on-street bike lane across Hewitt Street and Pedestrian Crossover
- No left turn facilities to English Street. Intersection is not signalized.
- English Street reconstruction in 2021
- Cycle Track behind on-street bus stop

london.ca



Proposed Layout

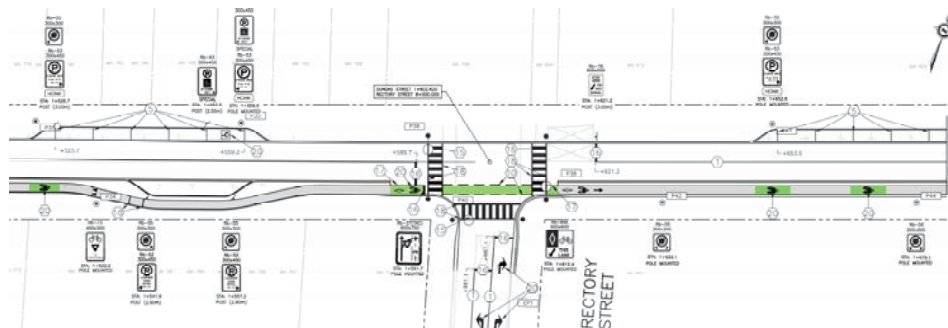


Rectory Street Intersection

- Converts to on-street bike lane across Rectory Street

london.ca



Proposed Layout

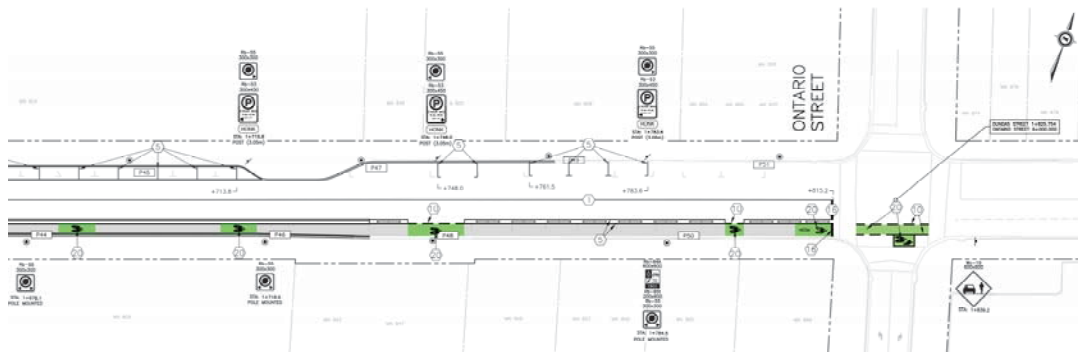

Ontario Street Intersection

- Cycle track converts to on-street separated bike lane approaching Ontario Street
- Precast curbs and flexible bollard design (similar to King Street & Colborne Street)
- Existing curb and roadway to remain. Future reconstruction as part of BRT Project
- Two stage left turn queue box added at Ontario Street

london.ca



Discussion



london.ca




Attachment: Contract Drawings

C21 to C23 – Pavement Markings and Signage

london.ca

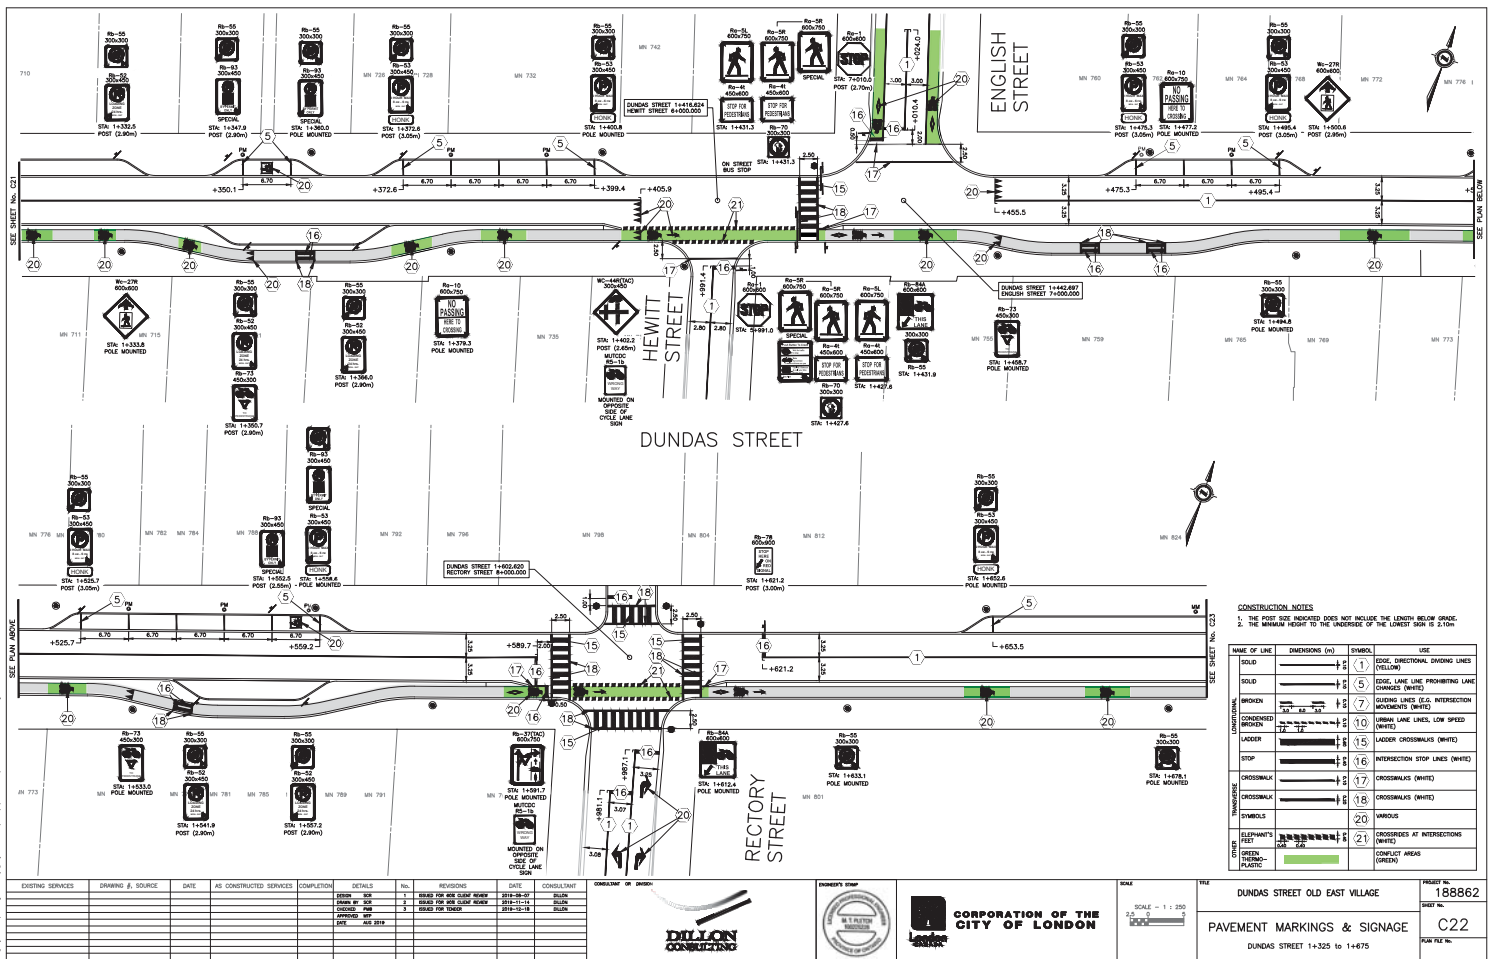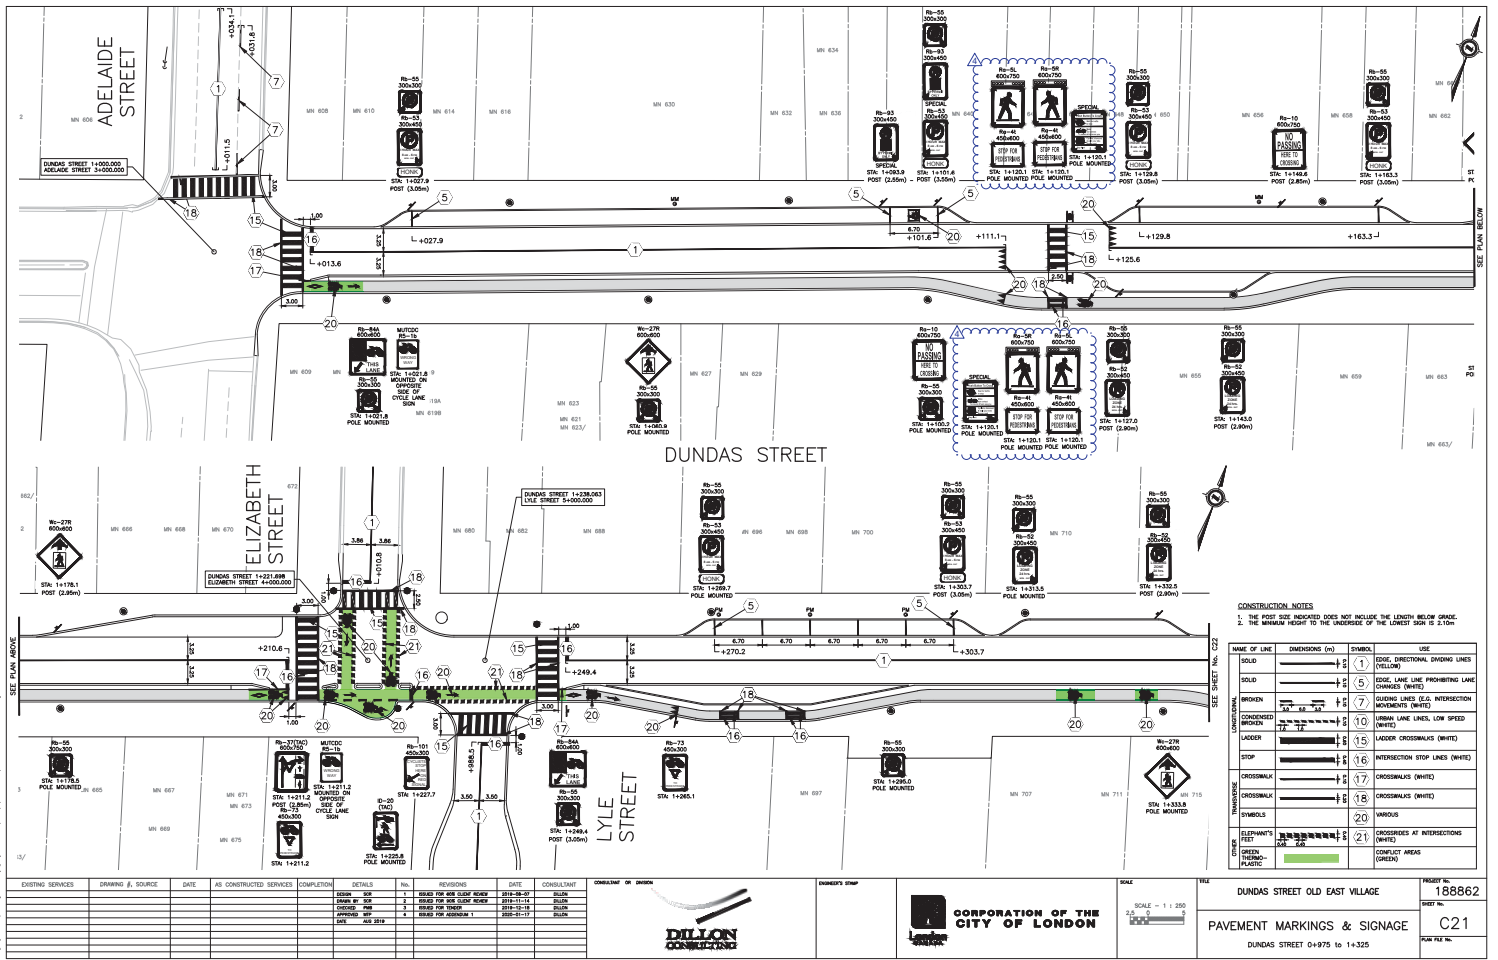

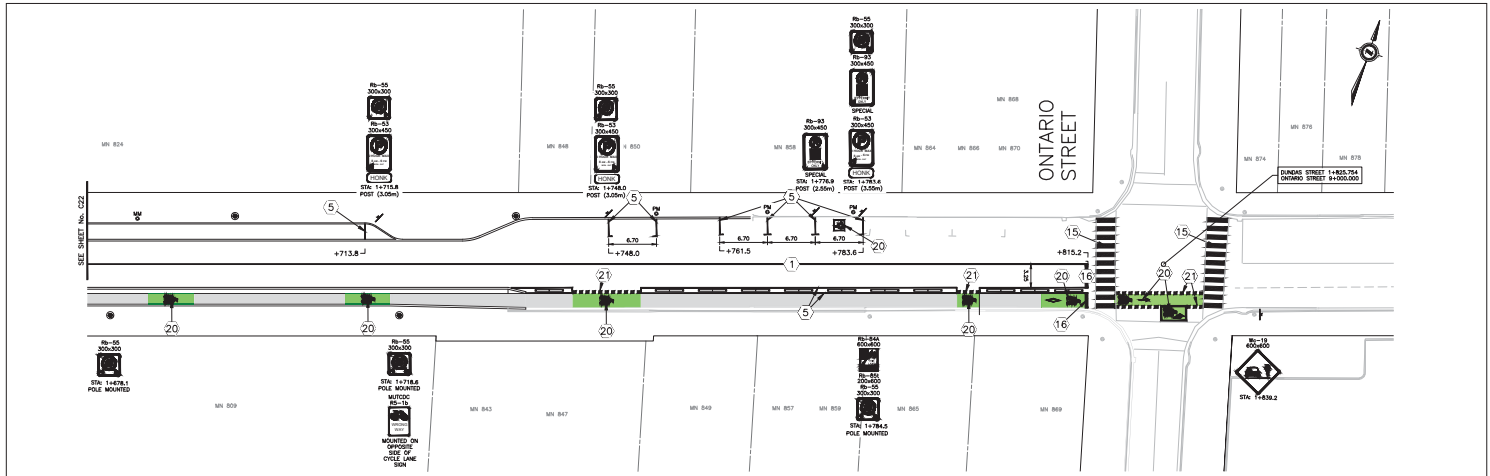

CONSTRUCTION NOTES


	PLASTIC		

EXISTING SERVICES	DRAWING #, SOURCE	DATE	AS CONSTRUCTED SERVICES	COMPLETION	DETAILS	NO.	REVISIONS	DATE	CONTRACT



SCALE


0 5 10

0 5 10

CORPORATION OF THE CITY OF LONDON

PROJECT NO.	188862
SHEET NO.	C23
FILE NO.	
DUNDAS STREET 1+675 TO 1+850	

